

July 3, 1917
F.A. Dixon Reg Engr

Robert M. & Iona Laughlin
to

The following described Real Estate situated
in Section 16, Town 6 West, Range 12 North,
Rome Township, Athens County, Ohio.

Starting at a stone at the North
East corner of Drantors Tract, said stone
being located on the North line of section
16 at the Northwest corner of Lot 4;
Thence South $0^{\circ}-17'-38''$ West 1013.19 feet
to an iron pin located on the center line
of County Road #192; Thence South $89^{\circ}-13'-30''$ West
428.57 feet to a bolt in the center of said
road passing an iron pin at 200 feet; Thence
North $81^{\circ}-19'-30''$ West ^{541.6 feet} to a R.R. spike; Thence
North $9^{\circ}-56'-36''$ West 658.52 feet to an iron
pin located on the North property line
of Drantors Tract passing an iron pin
at 11.53 feet; thence North $61^{\circ}-15'-27''$ East
742.17 feet to a stone in the Northeast
corner of Drantors Tract said stone
being the point of beginning; containing
11.6474 Acres.

The described Tract being the North
East corner of 78.64 acres conveyed to
Drantors by Deeds Recorded in Volume
226 page 14 and Volume 254 page 307-311
Athens County Records of Deeds.

See #16 Rome

SEC 17

stone

HERBERT J. HART
237-49
44.0 AC

N61°15'27"E 742.17

JAMES & JEAN GRAHAM
312-435



11.6474 ACRES

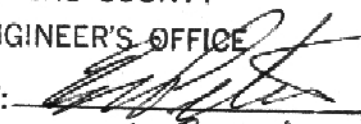
S-0°17'38"W 1013.19

SURVEY OF 11.6474 ACRES SITUATED
IN SECTION 17 TOWN 6 RANGE 12
ROME TWP. ATHENS CO. OHIO FOR
ROBERT M. & IONA LAUGHLIN
SOLD TO
SURVEYED BY F.A. DIXON
JULY 2, 1974 REG ENGR. 9786
Scale 1"=100 SURV. 3060

N9°56'36"W 658.52

ROBERT M. & IONA
LAUGHLIN
226-14 & 254-307, 310

Description checked for
Mathematical Accuracy
ATHENS COUNTY
ENGINEER'S OFFICE

BY: 
DATE: 7-9-74

N81°19'30"W 428.57
S-89°13'30"W 3.00

1153 RR SPIKE

BOLT

PREVIOUSLY SOLD

CO. ROAD #192
7-192

GEO. W. & PAULINE ROWE
312-689