




- = iron pin 5/8" found
- = iron pin 5/16" SET
- ▲ = Railroad Spike SET
- = P.K. SET

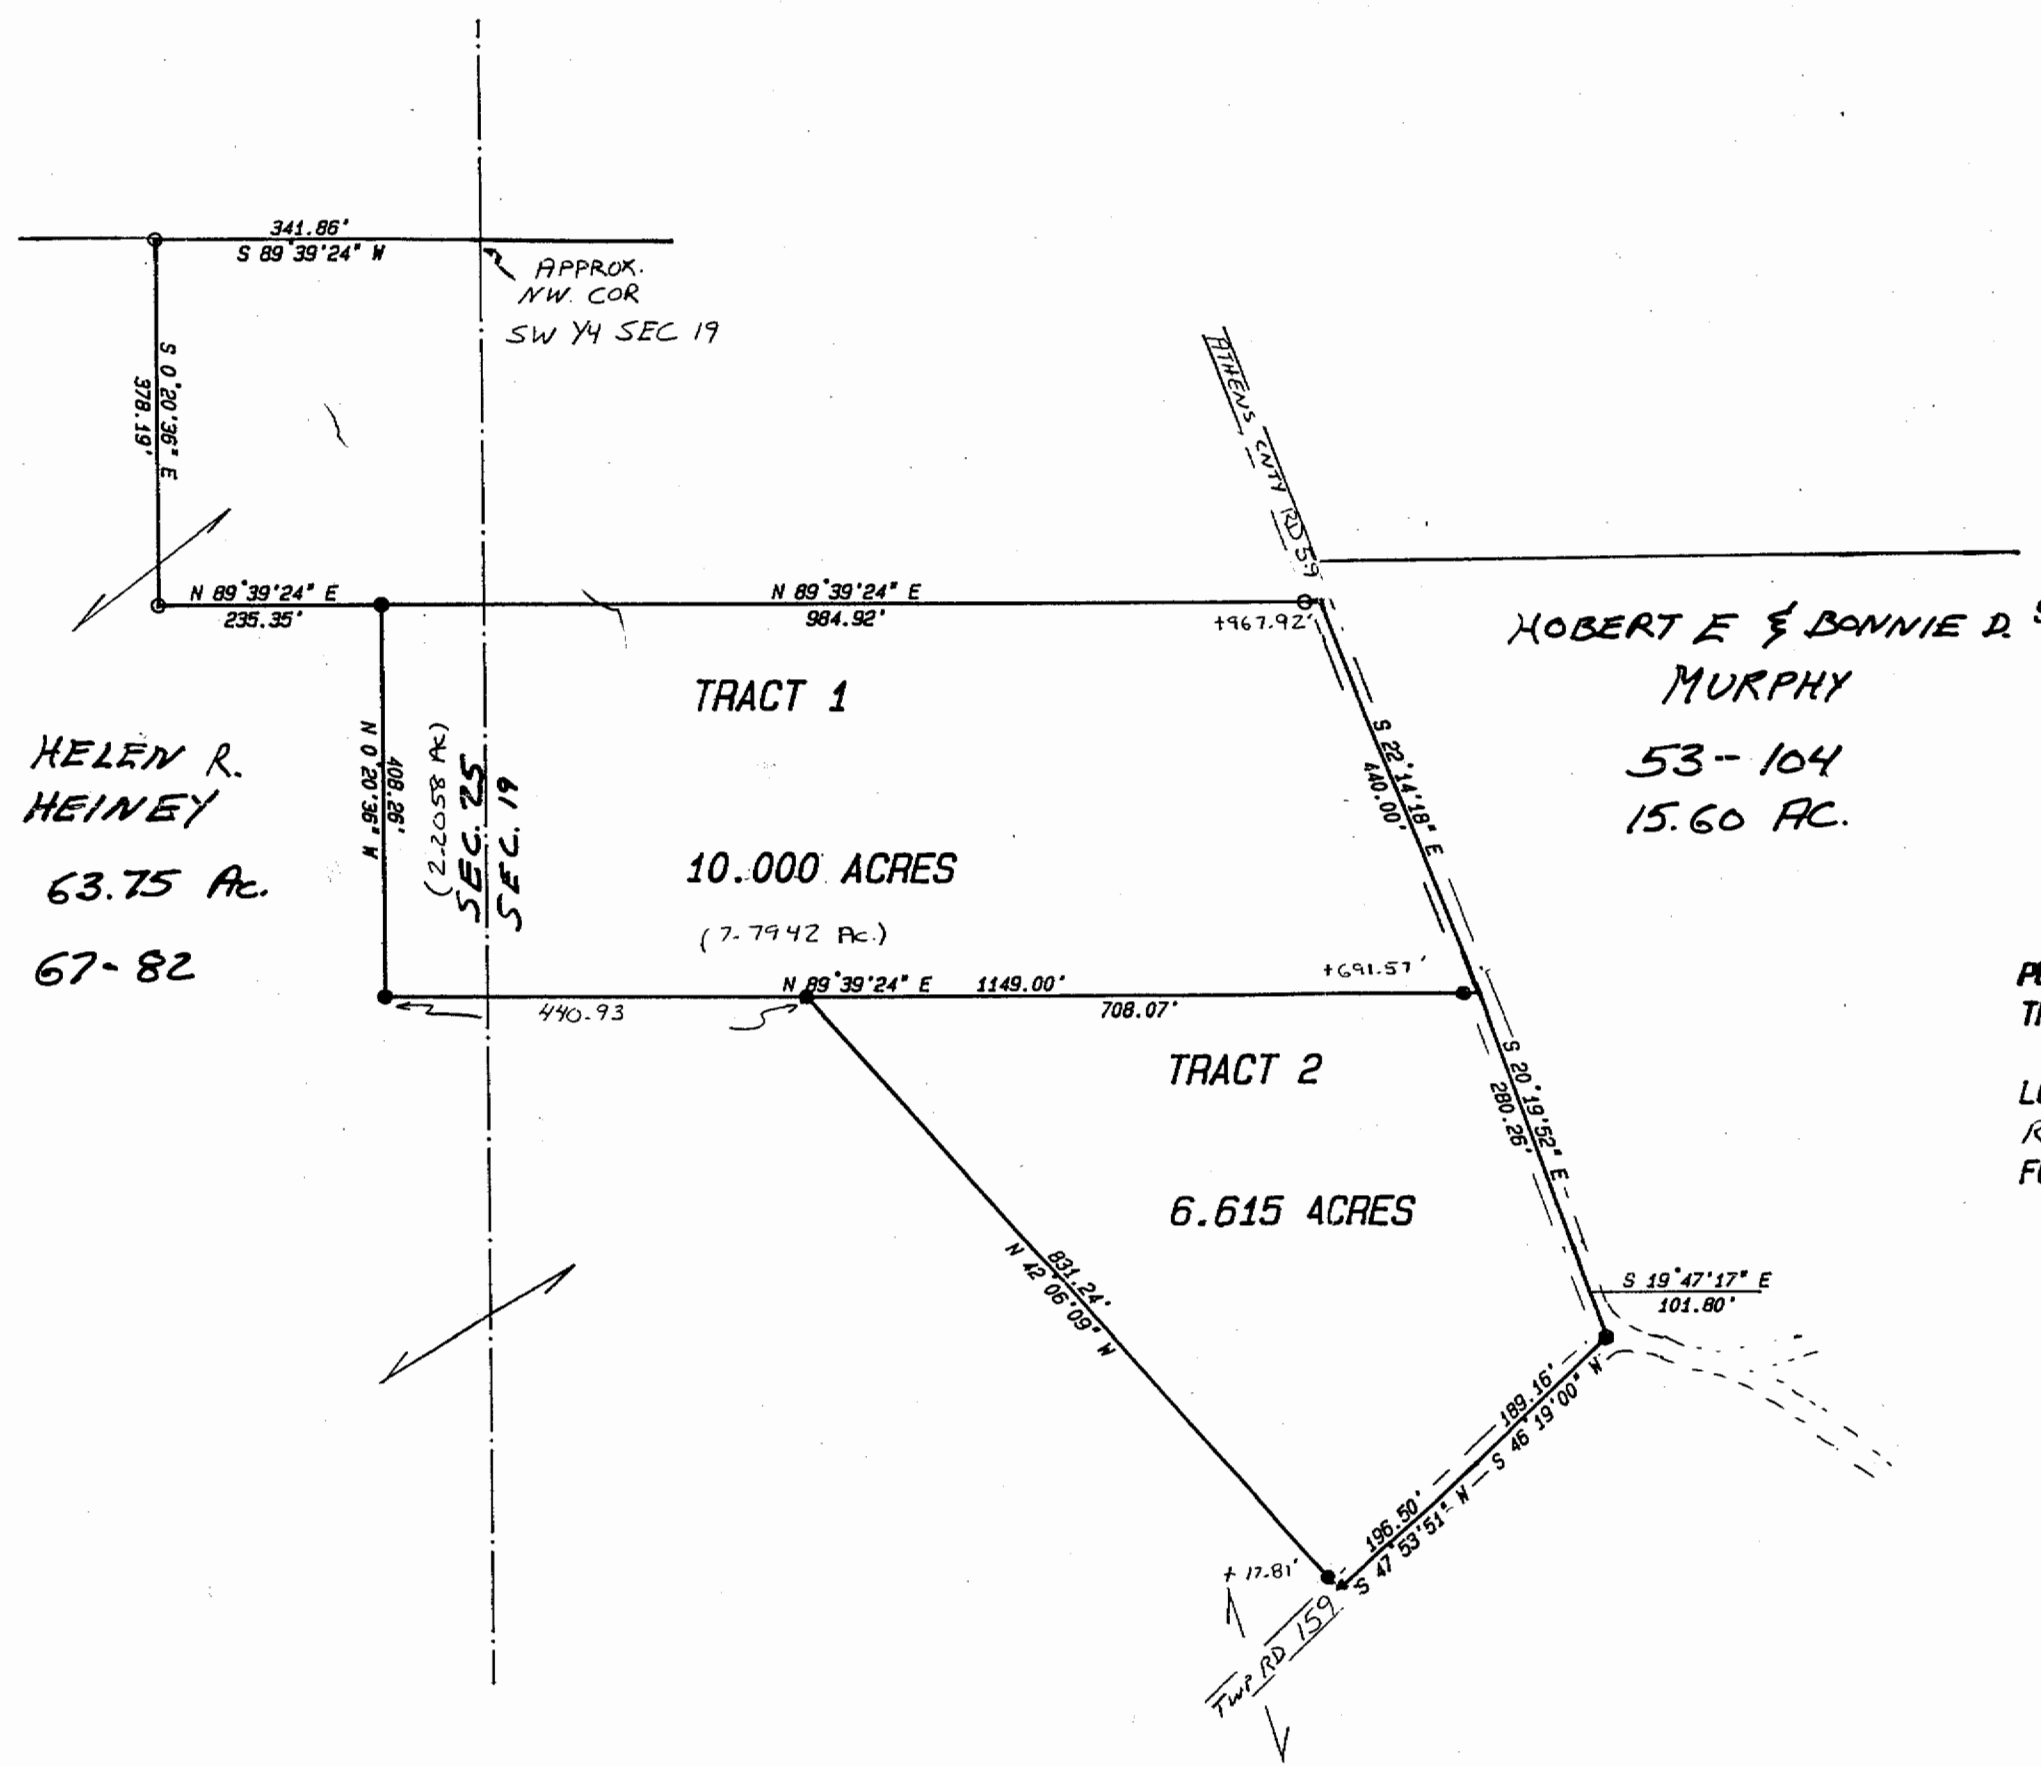

HELEN R.
HEINEY
63.75 Ac.
67-82

TRACT 1
10.000 ACRES
(7.7942 Ac.)

TRACT 2
6.615 ACRES

ROBERT E & BONNIE D. SCALE 1=200
MURPHY
53-104
15.60 AC.

PLAT OF SURVEY OF TWO TRACTS:
TRACT 1=10.000 ACRES, TRACT 2=6.615 ACRES
LOCATED IN SEC. 25 & 19, TOWN 5
RANGE 11, TROY TWP, ATHENS CNTY, OHIO
FOR GRAVIER & OSBORN

PREPARED BY
SOUTHEASTERN LAND
SURVEYS

DATE: 4/4/90

Leonard F. Swoyer Jr.
LEONARD F. SWOYER JR. RLS 6765