


Sec. 16

Sec 16
Troy

Fence lines

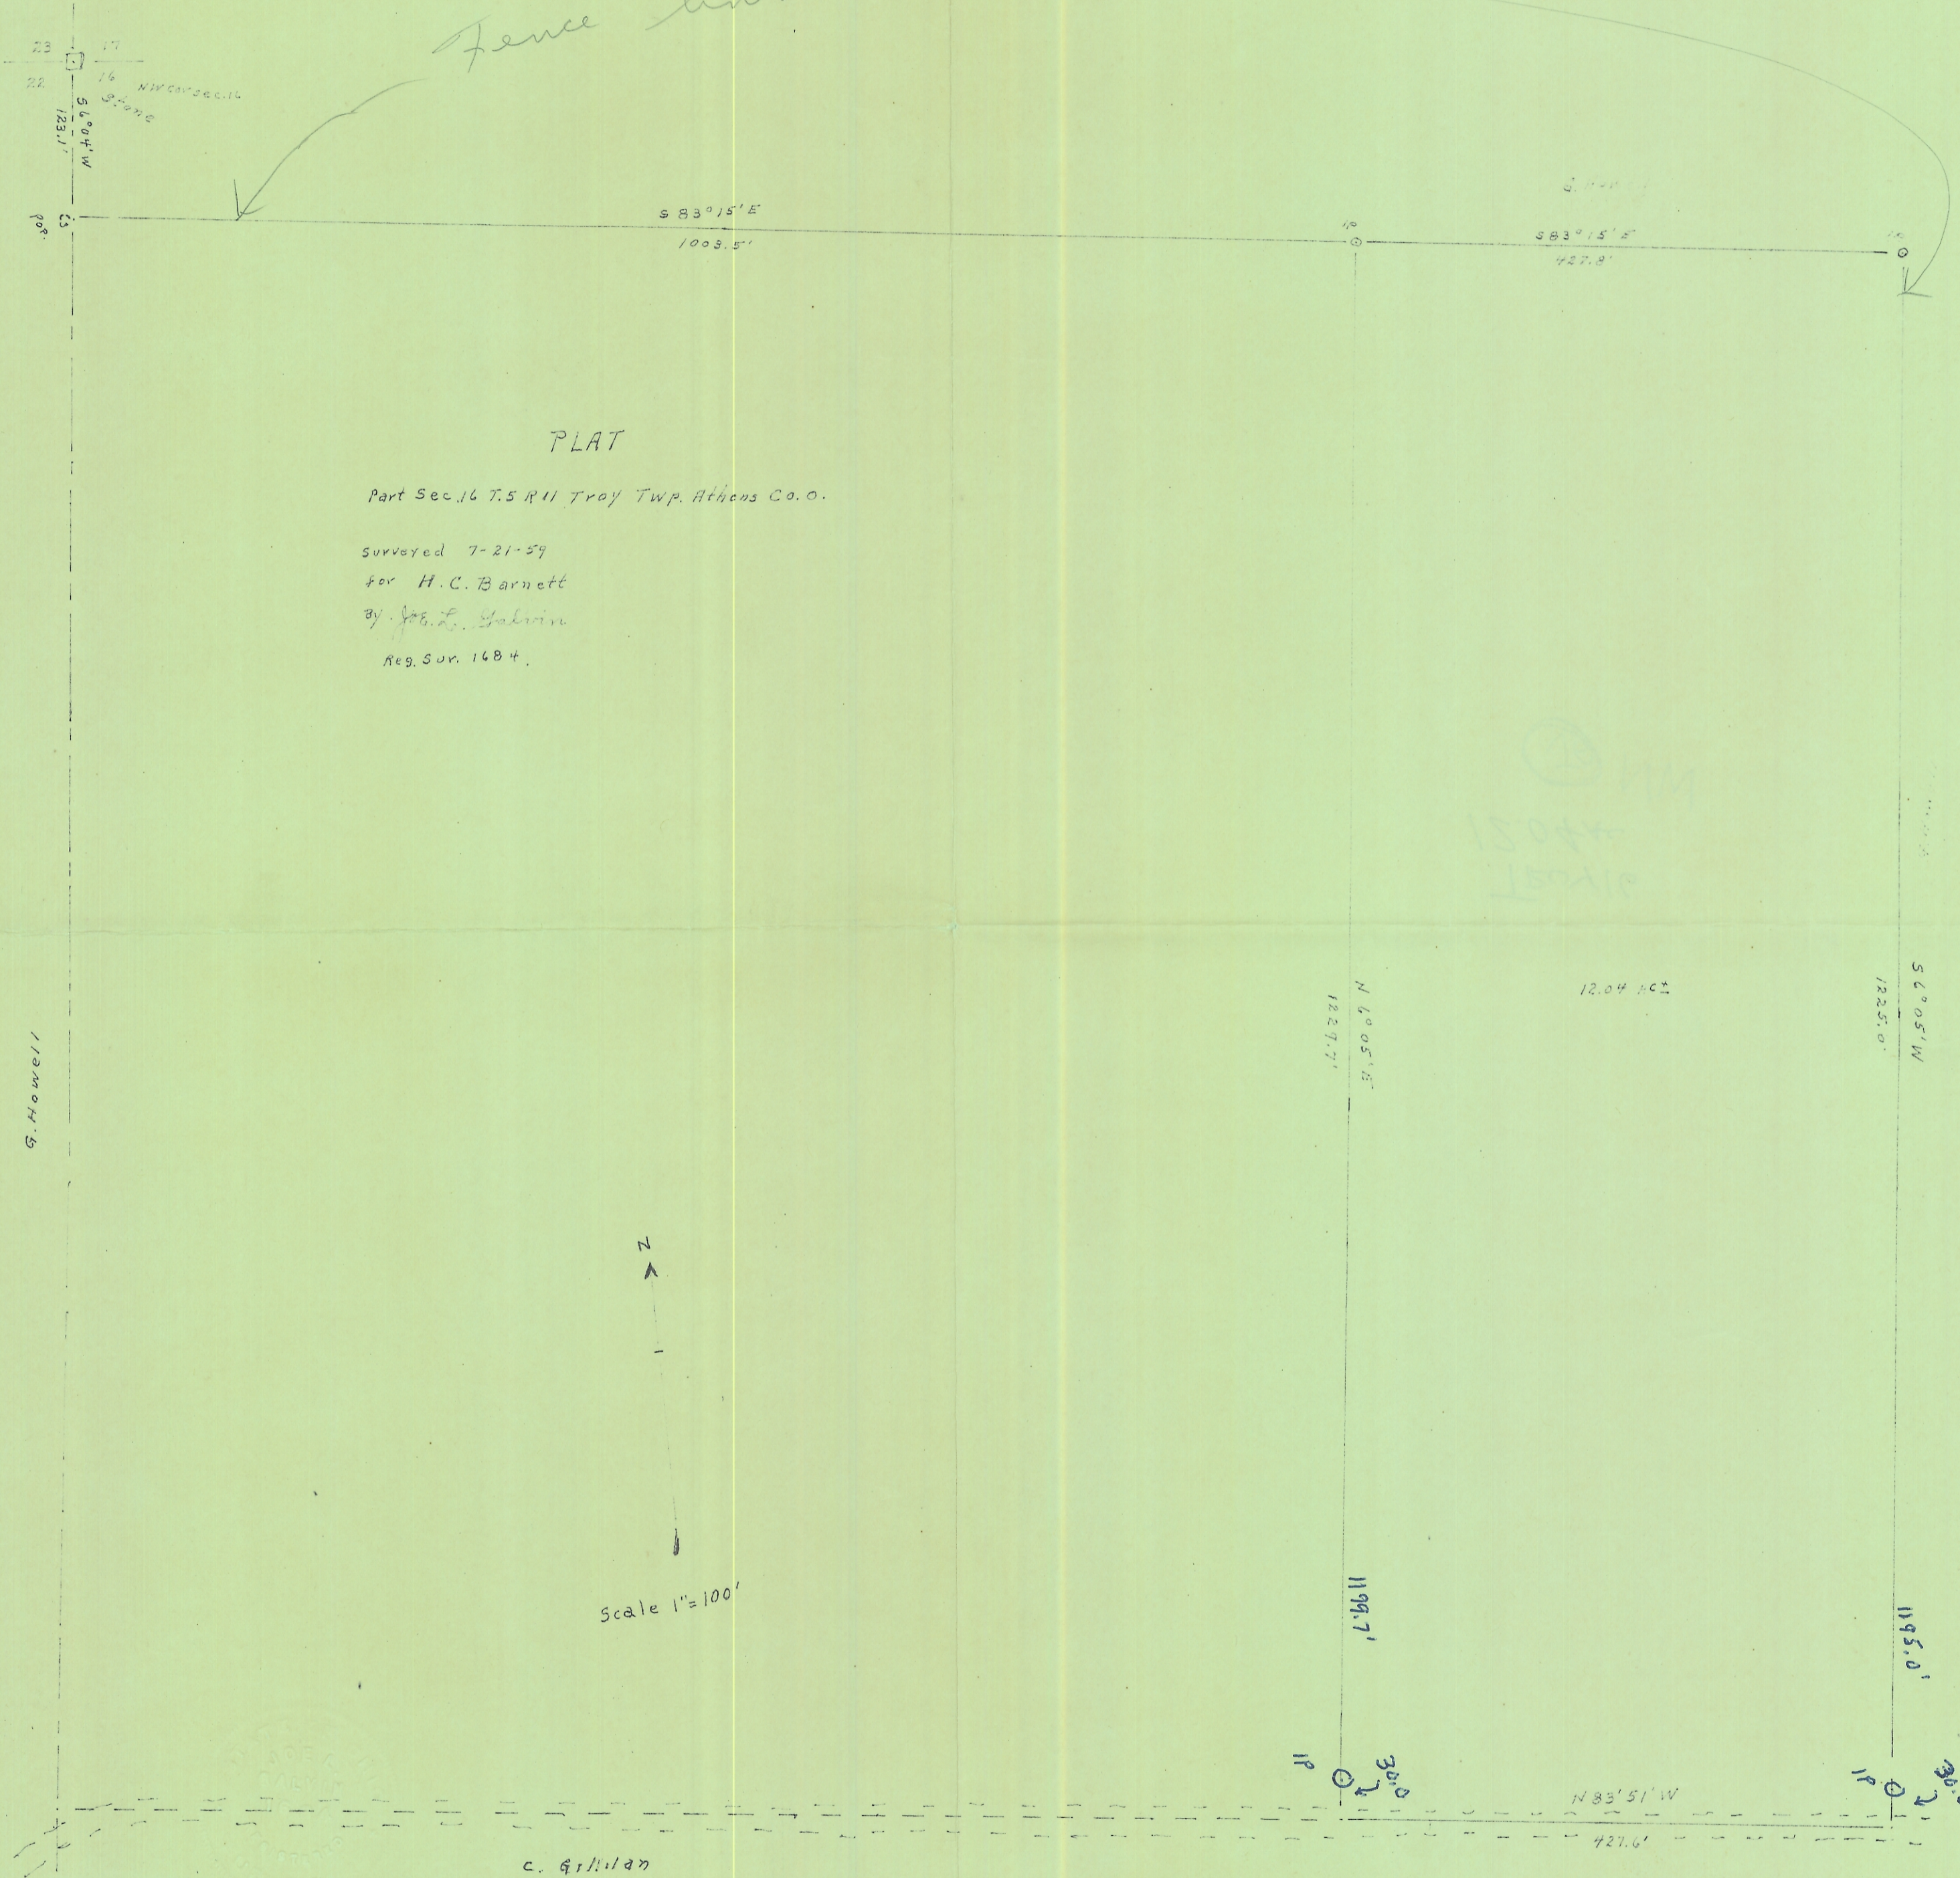

PLAT

Part Sec. 16 T. 5 R. 11 Troy Twp. Athens Co. O.

Surveyed 7-21-59
for H. C. Barnett
By J. G. L. Galvin

G. Howell

North arrow
Scale 1"=100'



12.04 ACRES

1P
3rd

1P
3rd