

HIGHLAND SURVEYING LTD.

Phone 740-753-1264
Fax 740-753-1264

80 Fayette St.
Nelsonville, Ohio 45764

Description of a 0.302 Acre Tract

Situated in 8 Acre Lot 1059, Section 7, T-5, R-11, Troy Township, Athens County, State of Ohio and being a part of a tract described in Deed Volume 265, Page 337 and being more particularly described as follows:

BEGINNING at an iron pin found that bears North $70^{\circ}36'08''$ West, 1698.37 feet from the Southeast corner of 8 Acre Lot 1053,

THENCE along the line of Holsinger (OR Vol. Page), South $6^{\circ}34'02''$ West, 77.93 feet to an iron pin set,

THENCE along a new line North $86^{\circ}41'59''$ West, 167.94 feet to an iron pin set,


THENCE along the State of Ohio (OR 407-668) tract the following two lines,
1) North $0^{\circ}06'00''$ East, 25.33 feet to an iron pin found,
2) North $9^{\circ}55'57''$ East, 52.87 feet to an iron pin found,

THENCE along the line of Holsinger (329-887), South $86^{\circ}41'51''$ East, 167.69 feet to the point of beginning and containing 0.302 acres.

This is an adjoining owner transfer and this tract must remain continuous and contiguous with the tract to the East

Bearings are to an assumed meridian and are for angular determination only

Subject to all Easements and Rights of Way of Record

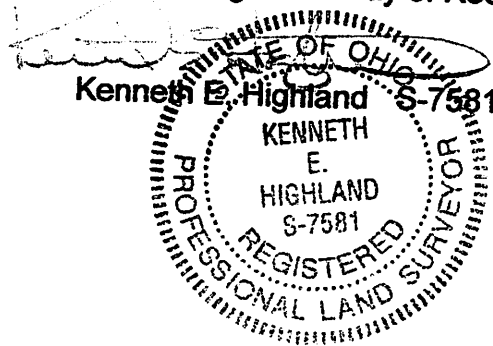

Description Checked for
Mathematical Accuracy
Athens County
ENGINEER'S OFFICE
BY: K. Canterbury
DATE: 5-12-09

1059

1058

Ketchum Ltd.
21-406 OR

Ketchum Ltd.
137-44 OR

Ketchum Ltd.
137-44 OR

Holsinger
329-887
(State of Ohio)
(Pending)

P.O.B. bears n 70° 36' 08" W,
1698.37' from the S.E. corner
of 8 Acre Lot 1053 (calc.)

NOTE: This tract
is an Adjacent
owner transfer

0.302
Acres

1.843
Acres

Line	Bearing	Distance
1	N 89° 47' 52" E	66.52'
2	N 0° 08' 00" E	25.33'
3	N 9° 55' 57" E	52.87'

o = Iron Pin Set
● = Iron Pin Found


State of Ohio
407-668 OR

Snyder
265-337

Description Checked for
Mathematical Accuracy
Athens County
ENGINEER'S OFFICE

BY: *K. Canterbury*
DATE: *5-12-09*

Scale 1" = 60'

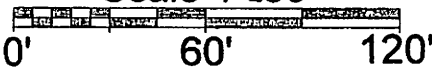

Cedar St.

PLAT OF SURVEY OF 2 TRACTS

SURVEYED FOR HOLSINGER

SUBDIVISION 8 ACRE LOTS 1058 & 1059

TOWNSHIP TROY SECTION 7 TOWN 5 RANGE 11

CORPORATION HOCKING PORT COUNTY ATHENS STATE OHIO

SCALE 1" = 60' DATE MAY, 2009

Kenneth E. Highland
80 Fayette St.
Nelsonville, Ohio 45764
740-753-1264

Kenneth E. Highland S-7581

