

Gater
Brenda S.
104-179 D.R.

Gater
Brenda S.
347-721 D.R.


Kovach
Harriet L.
548-473 O.R.

Gater
Brenda S.
382-468 O.R.

Tract A 46.389 Acres


Swart
Kevin L. Et al.
541-1533 O.R.
N010010016200

Woodcock
Nature Preserve Inc.
430-2064 O.R.

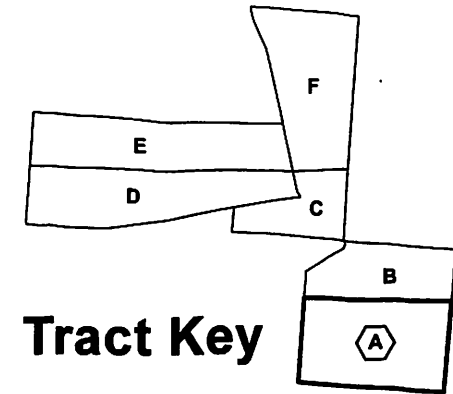

Tract Key

Weiss
Dwight E. Jr.
472-508 O.R.

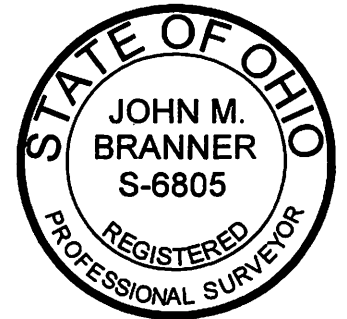

Survey of a 46.389 Acre tract
Situating in Section 13, T.11, R.15,
Waterloo Twp., Athens Co., OH
Surveyed December, 2018
by Jeb Branner, S.I., E.I.,
under the supervision of:

By: *John M. Branner*
P.O. Box 274
The Plains, OH 45780



Scale 1"=300'

○ = Iron pin set 5/8" rebar w/ plastic ID cap

● = Iron pin found

Bearings: N.A.D. Grid North - Ohio South Zone

Ref. Docs.: Tax Plats, Deeds, Existing Surveys

Description Checked for
Mathematical Accuracy
Athens County
ENGINEER'S OFFICE

BY: *Jeb Branner*
DATE: *12/18/18*

P.O.B.
Fence Corner found, taken
to be the Southeast Corner of
Section 13, Waterloo Township

