N°233. IN SECTIONS 35 & 36 T. 12 R 15 — YORK TP.

OLD SURVEYS
BK. S-122
PAGE

WITNESS TREES.

① { Hickory 10" N 41 W 24.4 ft
Poplar 18" S 79 E 34½ ft } 1840

② { White Oak 36" original
Chestnut 24 N 65 W 27½ ft.

③ { Beech 20" S 24 E 12 ft.
Gum 15" N 38 E 15½ "

④ { Beech 8" S 82 E 23½ ft.
Poplar 6" S 65 E 6 ft.

5 { Elm 6" N 16¾ E 93½ "
Honey Locust 6" N 2¼ E 99 "

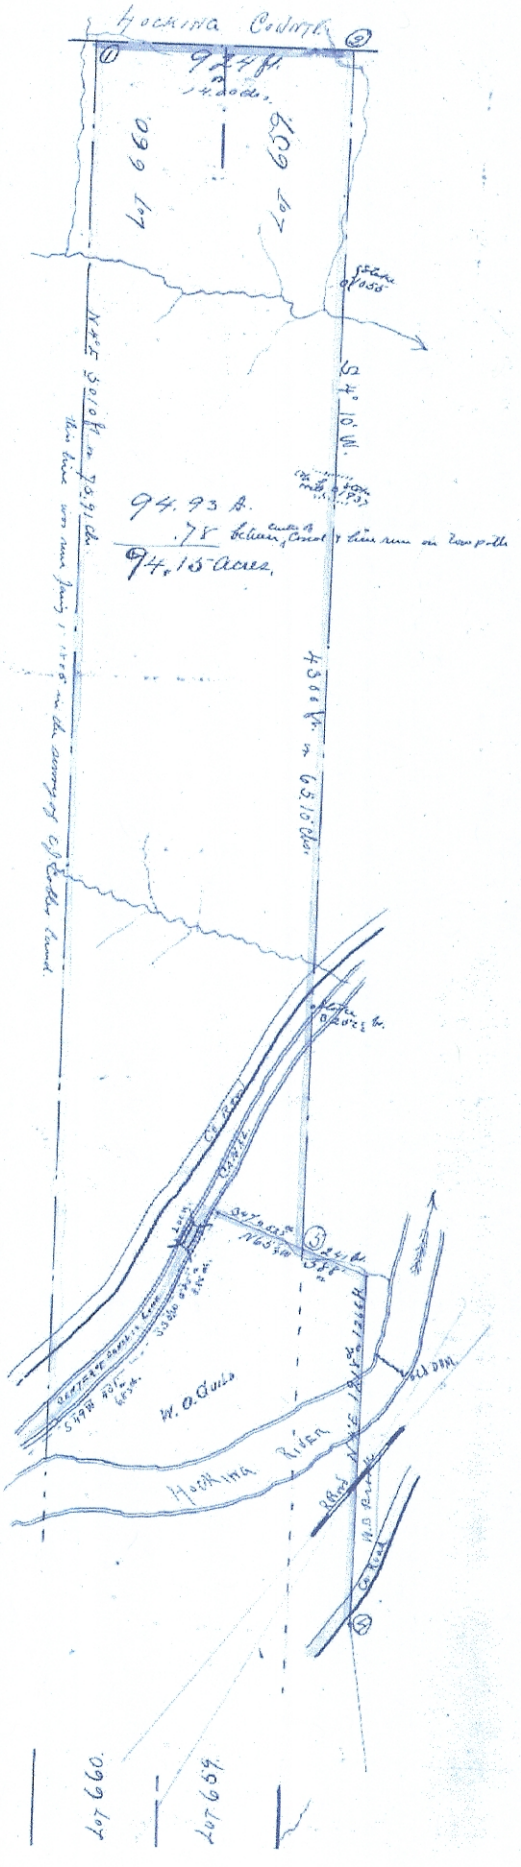

The line 2. 5 & 3 was run by back and fore sights — a carefully run "transit line". We missed the corner at 3 eleven feet to the west. We, therefore, had to set all stakes on our line, to the East one foot per thousand feet. I located the stakes at "5" & "3252½" in their proper places and instructed Mr. "Boss" Riser to move the stake at "1055" one foot to the East and the stake at "1937" two feet to the East.

Bearings Corrected to the true meridian at Athens Ohio.

Steele tape & plummet measurement —— Scale 1800 = one inch.

Surveyed April 17 & 18 1889.
for "Boss" Riser, agent

Recorded April 24 1889.
W. E. Peters
County Surveyor.

"Boss" Riser
Charles Riser
Charles Vore
A. P. Newton
James Harlgrove } Assistants.