

TO: LOBY  
FROM: KEN

# DPH SURVEYING, INC.

CONSULTING ENGINEERS AND SURVEYORS  
P.O. BOX 429 THORNVILLE, OHIO 43076  
OHIO PHONE: 1-800-648-8151 FAX NO. 1-800-648-8150

PROPERTY LOCATION


SITUATED IN THE STATE OF OHIO, COUNTY OF ATHENS, TOWNSHIP OF YORK, SECTION 6, T-12, R-15, AND IN THE VILLAGE OF BUCHTEL.

PREPARED FOR:

JEFF MURPHEY  
17705 BANK STREET  
BUCHTEL, OHIO 45716

REFERENCE MATERIAL:

O.D.O.T. RIGHT-OF-WAY MAPS FOR STATE ROUTE 78  
SURVEY OF LOTS 363, 361, 360, 367, 368 BY  
GREGORY K. WRIGHT S-6535 ON 9/15/86

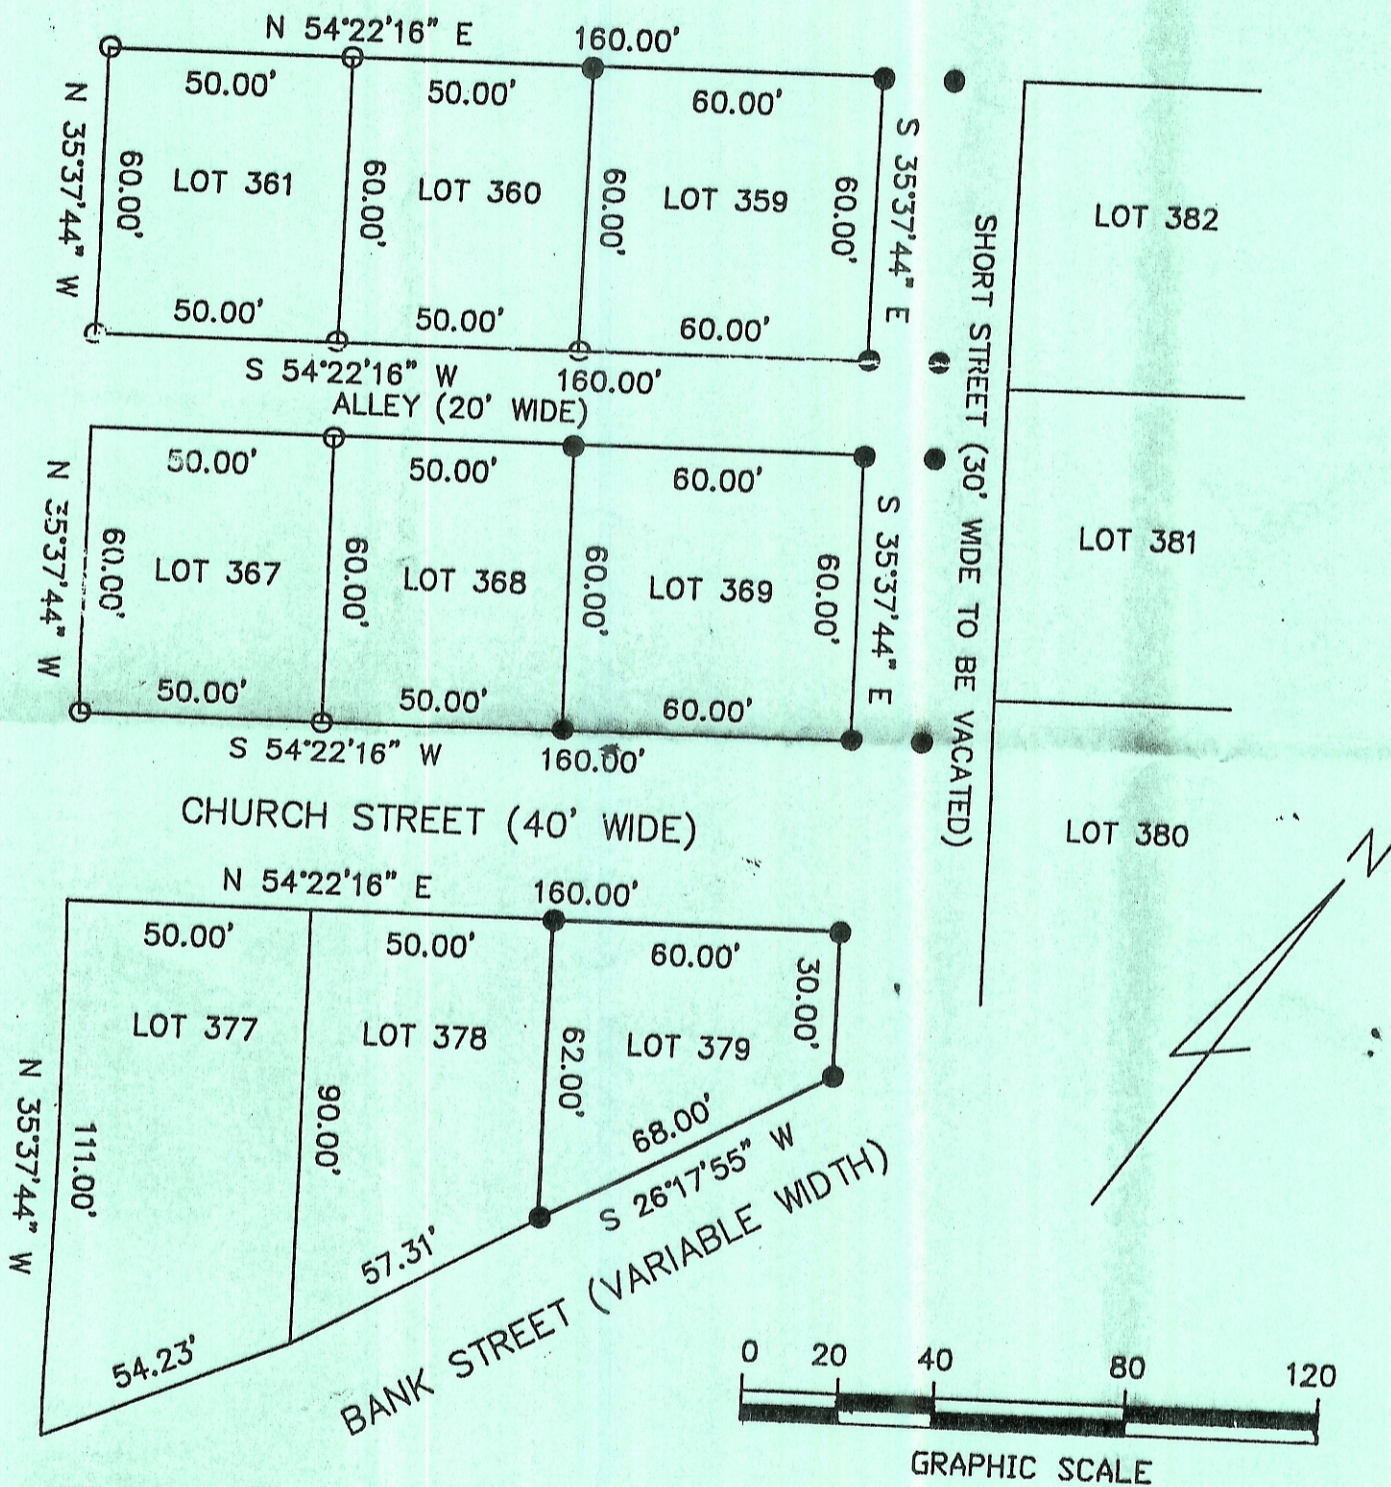


LEGEND

- - IRON PIN FOUND
- - IRON PIN SET
- △ - RAILROAD SPIKE FOUND
- ▲ - RAILROAD SPIKE SET

NOTE: ALL PINS SET ARE 5/8" O.D. IRON REINFORCING BARS WITH YELLOW CAPS LABELED "DENNIS P. HAGAN #6917"

I HEREBY CERTIFY THAT AN ACTUAL SURVEY WAS MADE OF THE PREMISES AND THAT THIS PLAN IS CORRECT TO THE BEST OF MY KNOWLEDGE.

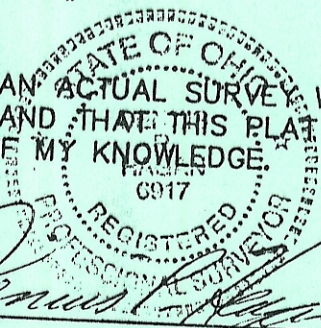

DATED 6/22/94 *Dennis P. Hagan*  
DENNIS P. HAGAN P.E., P.S.  
OHIO REGISTERED SURVEYOR #6917

BEARINGS OF THIS PLAT ARE BASED ON THE SOUTHERLY RIGHT-OF-WAY LINE OF HUNGARIAN STREET (VACATED) AS BEING N 54 22'16" E AS PREVIOUSLY SURVEYED BY GREGORY K. WRIGHT S-6536 ON 9/15/86.