

SCHEDULE B PROPERTY


No.	Grantee	Instrument	Date	Record	Cont. No.	Remarks
1	Ed J. Allen	18 8 14 Pl. Co.	Apr 16, 1893	28 173 220	149, 155	27
2	(This number not used)					42
3	(No paper life found)	Held by whose possession and claimed by Pl. Co.				43
4	Trustees of Trimble	18 11 17 Pl. Co.	Sept 23, 1894	40 148 143	143, 149	45
5	Trustees of Athens Co.	O.C.R.R. Co.	Sept 23, 1894	Prohibe Court Journal 16 2188	639	

GLOUSTER
OHIO

ABANDONMENT STA. 0+20 to 463+20
THE PROPERTY WAS REDEEMED WITH
THE NEW YORK CENTRAL
RAILROAD COMPANY
ONE 31 1897
RECORDED IN L.S. COUNTY NO. 1778
DATED JUNE 18 1892

THE CLEVELAND AND OHIO CENTRAL RAILWAY
RIGHT-OF-WAY S.D. TRUCK MAP
KANAWHA AND MICHIGAN RAILWAY
OPERATED BY
THE NEW YORK CENTRAL RAILROAD CO.
BUCKINGHAM BRANCH
FROM STA. 0+00 TO STA. 93+60
SCALE 1" = 200'
DATE OF SURVEY 1892
DATE OF PUBLICATION 1892
OFFICE OF THE ENGINEER, CLEVELAND, OHIO

ATHENS COUNTY
TRIMBLE TOWNSHIP

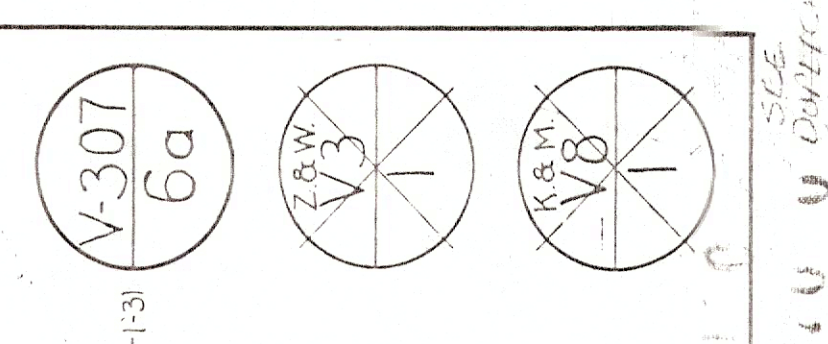

500 500 U