



AUTHORITY	DATE INSTALLED OR RETIRED	DESCRIPTION
C17804 A.R.E. 1542	Installed Sept. 30-1921	To protect fill from slipping 167 Piles.
A.R.E. 11495 C-28950	Retired May 28, 1924	Retirement of portion of interchange platform. Sta. 8273+25.
C22612 A.R.E. 7101	Completed Jan. 27, 1927	old east turnout of Th. P.S. at 8275+33.9 and west turnout of Th. 1243AII, P.S. opp. sta. 8273+37.6 removed. A new turnout was installed with a length of 16' between stations 8276+50.5, which lengthens Th. 116, present L. 3812'. A new turnout installed for Th. 1243AII, P.S. opp. sta. 8274+90.7, on Th. 116, 14' long, L. 382'. Distant signal formerly located opp. sta. 8274+59.8 relocated opp. sta. 8274+78. now located opp. sta. 8274+88.8. Distant signal formerly opp. sta. 8274+68.8 is now located opp. sta. 8274+47.7 and one additional signal added to home signal opp. sta. 8274+77.5 Installation of Flashlight Signals 165' to the left and right of stations 8274+71.4 and 8274+89.4. Retirement of Xing Signs and Xing Belts on the left and right of stations 8278+63.0, opp. sta. 8278+78.0, and 8278+86.0. The first interlocking changes and flashlight signals installation was borne: 50% Kanawha & Michigan R.R. (N.Y.C.R.R.) 50% B. & O. S.W.R.R.

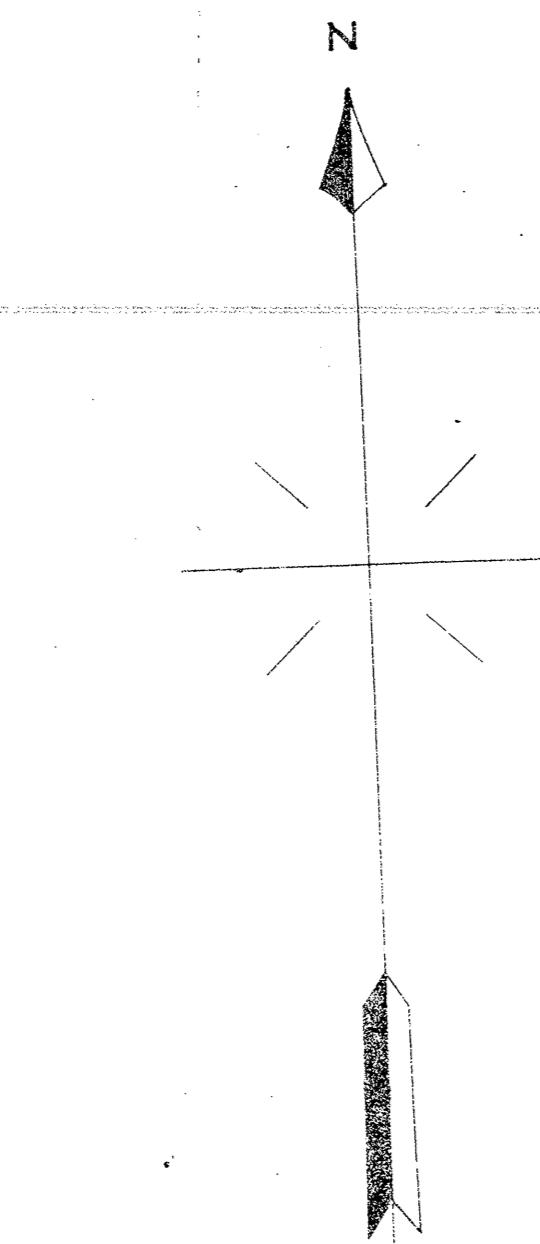

ATHENS CO., OHIO
ATHENS TWP.
T-9 N. - R14 W.

REVISED TO
May 31 1922
June 1 1925
Aug. 15 1925
Dec. 1 1927
Jan. 1 1928

 

THE BALTIMORE AND OHIO SOUTHWESTERN RAILROAD COMPANY
OPERATED BY

THE BALTIMORE AND OHIO RAILROAD COMPANY

OHIO DIVISION MAIN LINE

STATION 8236+80 TO STATION 8289+60

SCALE: 1 IN. = 100 FT. JUNE 30, 1918

OFFICE OF VALUATION ENGINEER
BALTIMORE, MD.

Sheet No. 53041 49 primary and 19 supplemental sheets of The Baltimore & Ohio Southwestern
R.R. Co., V-145.1, Ohio Division, Main Line, from survey station 8236+80 to survey
station 8289+60

a. m. Taylor
Pilot Engineer.

V.145.1
S-30